


As Built Floor Plan
Suite 430
The Brewery
Halifax, NS
Scale: 1/8"=1'-0"
December 6, 2010

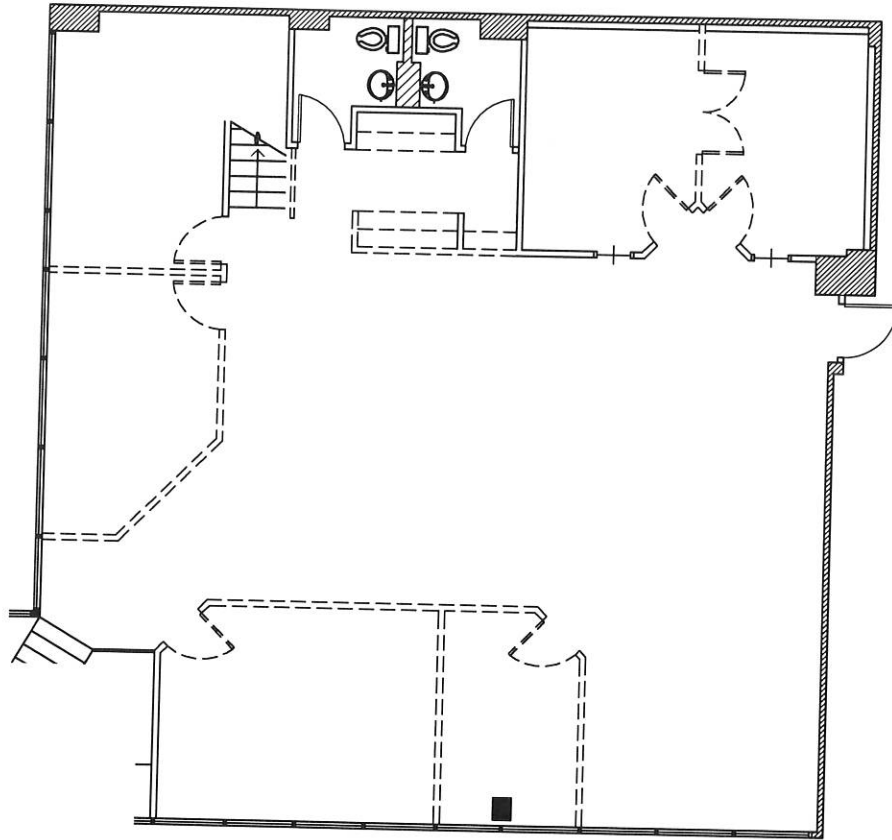

INTERIOR DESIGN

3045 Robie Street Suite 259
Halifax, NS B3K 4P6
TEL: 902-453-9267 FAX: 455-0004
EMAIL: conradid@ns.alfiantzinc.ca